

Title **Community Athletic Fields (CAF) -1375 N. Arlington Hts Rd.** 10/12/2021
id. 21503356
by **Valerie Lemme** in **Member District ADA Project Request**
VLEMME@ELKGROVEPARKS.ORG

Original Submission 10/12/2021

Name	VALERIE GERDES LEMME
Job Title	Landscape Architect
E-mail Address	vlemme@elkgroveparks.org
Phone Number	8472283513
Park District	Elk Grove
Project Location	Community Athletic Fields (CAF) -1375 N. Arlington Hts Rd.
Project Status	New
Project Type	Routes and Surfaces
Routes and Surfaces- select a Project Category below:	Ramps
Benefits of the Project	Previous access to the football field was an asphalt path with a very steep slope that was slippery when wet. New concrete ADA ramp was installed to provide an accessible route from the concession area and restrooms to the field.
Items that will become ADA Compliant	Ramp, handrails, connecting walk, access to restrooms and concession area
The project is designed or constructed, or applies human resources, to comply with:	The 2010 Standards for Accessible Design The Illinois Accessibility Code Agency's ADA Transition Plan

Upload Project Related Files, Photos, Videos or Audio

[Community_Athletic_Fields_2-26-21.pdf](#)

[2001753C_Elk_Grove_Athletic_Fields_Walk_As-Built_Topographic_Survey_7-16....pdf](#)

[Advantage_Paving_invoice.pdf](#)

[bid_notice_invoice.pdf](#)

[Itasca_permit_invoice.pdf](#)

[WT_C1_invoice_8_3_20.pdf](#)

[WT_C2_invoice_8_25_20.pdf](#)

[WT_C3_invoice_11_23_20.pdf](#)

[WT_C4_invoice_1_4_21.pdf](#)

[WT_C5_invoice_3-4-21.pdf](#)

[WT_C6_invoice_6_2_21.pdf](#)

[WT_C7_invoice_6-30-21.pdf](#)

[WT_C8_invoice_7_27_21.pdf](#)


Budget Table for ADA Related Expenses

[Budget Table.xlsx](#)

ADA Dollars Requested	57056.0
-----------------------	----------------

Notes related to requested amount	This ramp is now heavily used during the football season by all guests especially when the asphalt path is slick and wet. It makes it much easier for patrons to access the restrooms and concession area safely.
-----------------------------------	--



TOPOGRAPHIC SURVEY OF AS-BUILT CONDITIONS

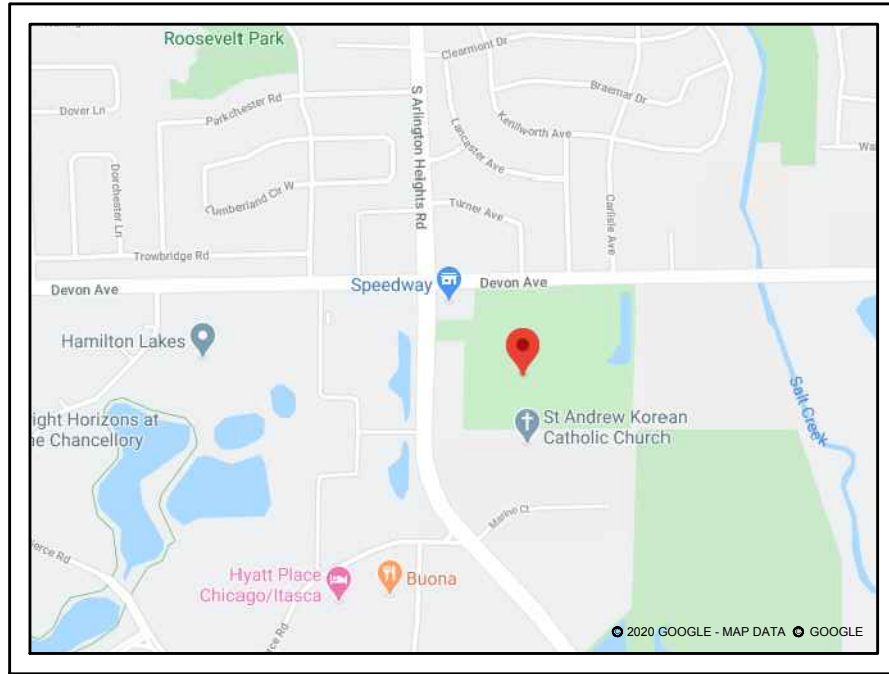


LOCATION MAP

SITE LOCATION

COMMUNITY ATHLETIC FIELDS – ELK GROVE PARK DISTRICT
DEVON AVE & ARLINGTON HEIGHTS ROAD
ITASCA, ILLINOIS.

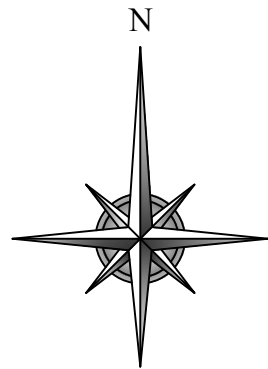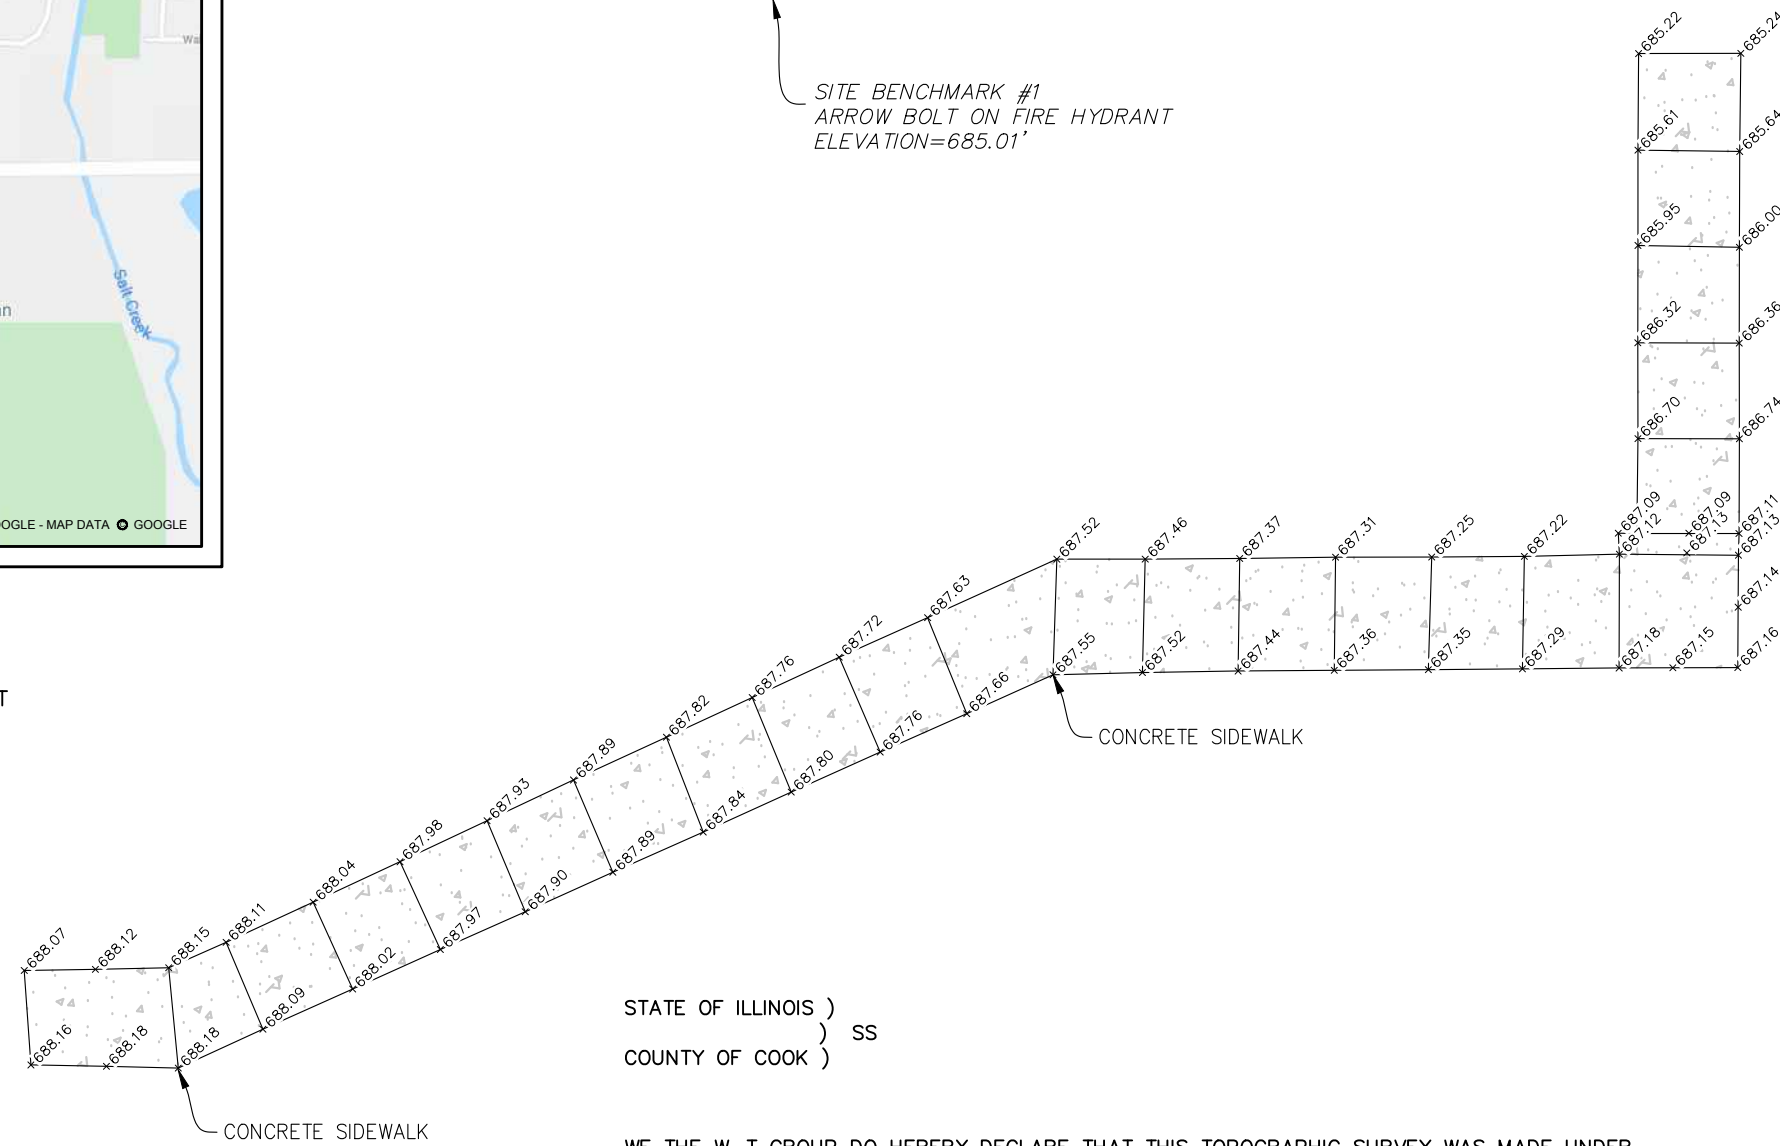

SCALE: 1" = 10'

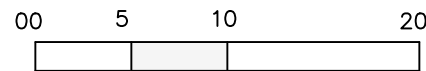

BAR SCALE

NOTES:

1. FIELD WORK COMPLETED ON JULY 1st, 2021
2. SURVEY PREPARED FOR: ELK GROVE PARK DISTRICT
3. ANY DISCREPANCIES FOUND WITHIN THIS DOCUMENT NEED TO BE REPORTED TO THE SURVEYOR AS SOON AS POSSIBLE.


STATE OF ILLINOIS)
) SS
COUNTY OF COOK)

WE THE W-T GROUP DO HEREBY DECLARE THAT THIS TOPOGRAPHIC SURVEY WAS MADE UNDER OUR DIRECTION AND SUPERVISION. THIS PROFESSIONAL SERVICE CONFORMS TO THE CURRENT ILLINOIS MINIMUM STANDARDS FOR TOPOGRAPHIC SURVEYS.

GIVEN UNDER OUR HAND AND SEAL THIS 16th DAY OF JULY A.D. 2021 AT HOFFMAN ESTATES, ILLINOIS.

THE W-T GROUP, LLC

Franjo I. Matić
FRANJO I. MATIĆ - PLS #035-003556 EXPIRES 11/30/2022
ILLINOIS PROFESSIONAL DESIGN FIRM LICENSE NO. 184.007570-0015

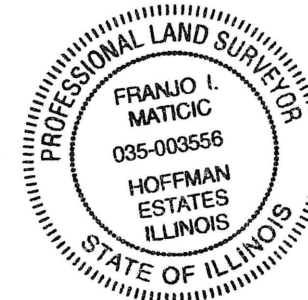

PREPARED BY:

Engineering • Design • Consulting
Structural | Mechanical/Electrical/Plumbing
Civil | Land Survey | Telecommunication | Aquatic
Accessibility Consulting | Design & Program Management
Engineering with Precision, Pace & Passion.

2675 Pratum Avenue | Hoffman Estates, IL 60192
P: 224.293.6333 | F: 224.293.6444
wtengineering.com

DATE : XX/XX/XX	SCALE : 1"=XX'
DRAWN : XXX	BOUNDARY : XXX
FIELD WORK : XXX	CHECK : XXX
JOB : SXXXXX	SHEET REVISION
S-1	OF ONE SHEETS

IL License No: 184.007570-0015 | Exp: 04.30.2023
© COPYRIGHT 2021 THE W-T GROUP, LLC



MEMORANDUM

TO: Park Board of Commissioners

FROM: Ben Curcio - Executive Director *Approved 4-0*

SUBJECT: Agenda Item – Pay Request Approval - Advantage Paving Solutions, Inc

DATE: July 2, 2021

Attached is Payment Application #1, from Advantage Paving Solutions, Inc. for services and materials for the Community Athletic Fields ADA Ramp project for a total of **\$41,806.04**.

Staff recommends and requests Park Board approval of the pay request for the previously approved agreement between the Elk Grove Park District and Advantage Paving Solutions, Inc., Joliet, IL 60433 in the amount of **\$41,806.04**.

Gr# 23-7-0001-740005

ELK GROVE PARK DISTRICT ELK GROVE VILLAGE, IL 60007

282614

01-4000 ** ADVANTAGE PAVING SOLUTIONS, INC. ** 282614 07/16/2021

DATE	I.D.	PO #	DESCRIPTION	AMOUNT
7/02/2021	202107135881		ADVANTAGE PAVING SOLUTIONS, IN	41,806.04

** ADVANTAGE PAVING SOLUTIONS, INC. **
 20502 S. CHERRY HILL ROAD
 JOLIET, IL 60433

CHECK TOTAL 41,806.04

APPLICATION AND CERTIFICATE FOR PAYMENT

TO OWNER:
Elk Grove Park District - Administrative Offices
499 Biesterfeld Road
Elk Grove Village, IL 60007
FROM CONTRACTOR:
Advantage Paving Solutions, Inc.
20502 S. Cherry Hill Road
Joliet, IL 60433

PROJECT:
Community Athletic Fields
Concrete ADA Ramp

VIA ARCHITECT:
N/A

APPLICATION #: 1
PERIOD TO: 06/30/21
PROJECT NOS: N/A

CONTRACT DATE: 03/26/21

Distribution to:
 Owner
 Const. Mgr
 Architect
 Contractor

CONTRACT FOR: Community Athletic Fields - Concrete ADA Ramps

CONTRACTOR'S APPLICATION FOR PAYMENT

Application is made for payment, as shown below, in connection with the Contract.
Continuation Sheet is attached.

1. ORIGINAL CONTRACT SUM----- \$ 42,006.04
2. Net change by Change Orders----- \$ -200.00
3. CONTRACT SUM TO DATE (Line 1 +/- 2) \$ 41,806.04
4. TOTAL COMPLETED & STORED TO DATE-\$ 41,806.04
(Column G on Continuation Sheet)
5. RETAINAGE:
a. _____ of Completed Work \$ _____
(Columns D+E on Continuation Sheet)
b. _____ of Stored Material \$ _____
(Column F on Continuation Sheet)
Total Retainage (Line 5a + 5b or
Total in Column 1 of Continuation Sheet----- \$ _____
6. TOTAL EARNED LESS RETAINAGE----- \$ 41,806.04
(Line 4 less Line 5 Total)
7. LESS PREVIOUS CERTIFICATES FOR PAYMENT
(Line 6 from prior Certificate)----- \$ _____
8. CURRENT PAYMENT DUE----- \$ 41,806.04
9. BALANCE TO FINISH, INCLUDING RETAINAGE
(Line 3 less Line 6) \$ _____

CHANGE ORDER SUMMARY	ADDITIONS	DEDUCTIONS
Total changes approved in previous months by Owner		-\$200.00
Total approved this Month		
TOTALS		-\$200.00
NET CHANGES by Change Order		-\$200.00


The undersigned Contractor certifies that to the best of the Contractor's knowledge, information and belief the Work covered by this Application for Payment has been completed in accordance with the Contract Documents, that all amounts have been paid by the Contractor for Work for which previous Certificates for Payment were issued and payments received from the Owner, and that current payment shown therein is now due.

CONTRACTOR:

By: David J. Furr Date: 6-30-21

State of: Illinois
County of: Will

Subscribed and sworn to before me this 30 day of June 2021

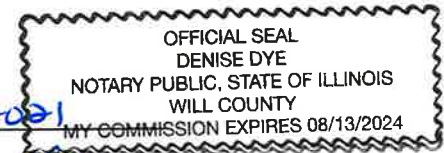

Notary Public: Denise Dye
My Commission expires: Aug 13, 2021

CERTIFICATE FOR PAYMENT

In accordance with Contract Documents, based on on-site observations and the data comprising application, the Architect certifies to the Owner that to the best of the Architect's knowledge, information and belief the Work has progressed as indicated, the quality of the Work is in accordance with the Contract Documents, and the Contractor is entitled to payment of the AMOUNT CERTIFIED.

AMOUNT CERTIFIED ----- \$ _____
(Attach explanation if amount certified differs from the amount applied for. Initial all figures on this application and on the Continuation Sheet that are changed to conform to the amount certified.)

ARCHITECT:

By: _____ Date: _____

This Certificate is not negotiable. The AMOUNT CERTIFIED is payable only to the Contractor named herein. Issuance, payment and acceptance of payment are without prejudice to any rights of the Owner of Contractor under this Contract.

COMMUNITY ATHLETIC FIELDS ELK GROVE

ADA RAMP

DEVON AVE. & ARLINGTON HEIGHTS RD.

ITASCA, IL 60143


DRAWING INDEX

SHEET	DESCRIPTION	DATE
T-1.0	TITLE SHEET	02-26-21
C-1.0	SITE DEMOLITION PLAN	02-26-21
C-2.0	SITE GEOMETRIC PLAN	02-26-21
C-3.0	SITE DEVELOPMENT PLAN	02-26-21
C-3.1 - C-3.2	SITE DEVELOPMENT DETAILS	02-26-21
C-4.0	SITE GRADING PLAN	02-26-21
C-5.0	SITE UTILITY PLAN	02-26-21
C-6.0	STORM WATER POLLUTION PREVENTION PLAN	02-26-21
C-6.1 - C-6.2	STORM WATER POLLUTION PREVENTION DETAILS	02-26-21
C-7.0	PROJECT SPECIFICATIONS	02-26-21
EX-1.0	EXISTING VS. PROPOSED CONDITION EXHIBIT	02-26-21
SUR-1	BOUNDARY AND TOPOGRAPHIC SURVEY (PREPARED BY WT GROUP)	01-14-21

BENCHMARK:

SITE BENCHMARK #1 - SET CROSS ON ARROW BOLT OF HYDRANT LOCATED IN GRASS APPROXIMATELY 3.42' S OF ASPHALT LOT AND 41.75' ENE OF MH #1, AS SHOWN. ELEVATION = 685.01' (NAVD88)

SITE BENCHMARK #2 - SET PK NAIL AT THE END OF PARKING STRIPE, 85' NM OF SITE BENCHMARK #1 AND 19' NE OF EXISTING MH#2 AS SHOWN. ELEVATION = 681.25' (NAVD88)

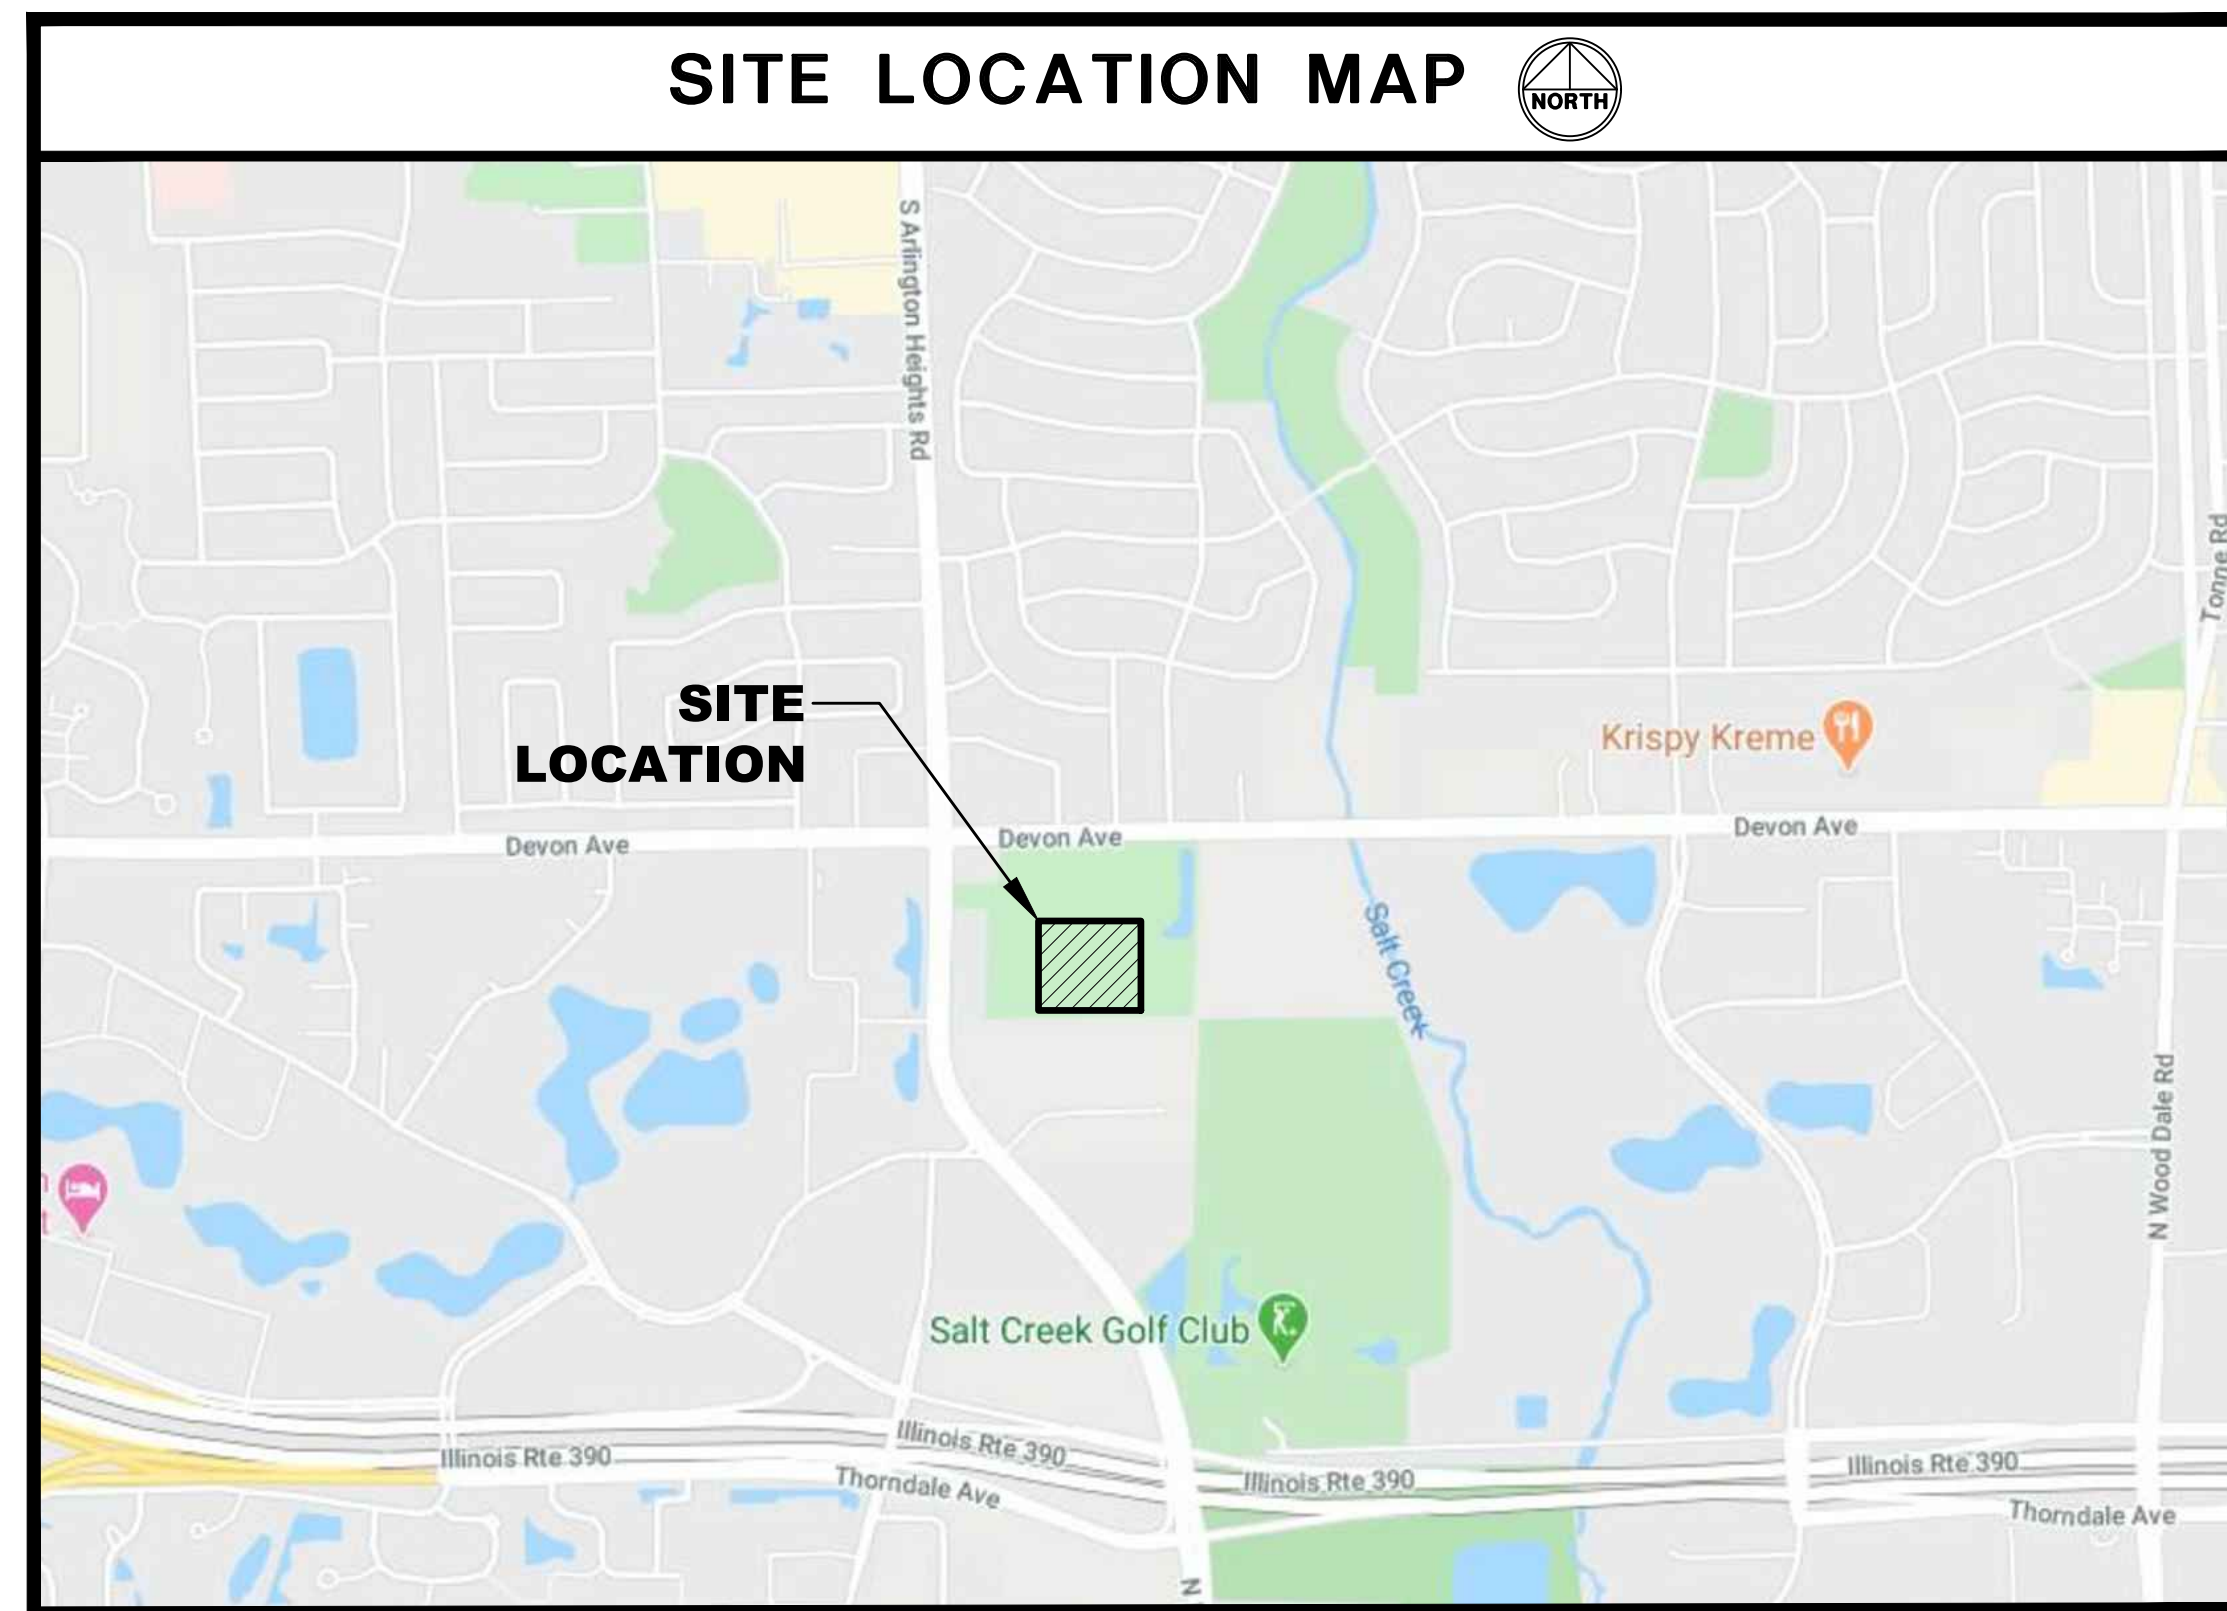

SECTION 05
TOWNSHIP 40N
RANGE 11E

CIVIL ENGINEERING STATEMENT AND SEAL

I, JASON E. GREEN, P.E., DULY LICENSED IN THE STATE OF ILLINOIS BY THE DEPARTMENT OF FINANCIAL AND PROFESSIONAL REGULATION, DO HEREBY STATE THAT THIS DOCUMENT WAS PREPARED BY ME OR UNDER MY DIRECT SUPERVISION AND TO THE BEST OF MY KNOWLEDGE AND BELIEF DOES CONFORM TO THE APPLICABLE BUILDING CODES AND ORDINANCES, AND ARE IN COMPLIANCE WITH THE ENVIRONMENTAL BARRIERS ACT [410 ILCS 25] AND THE ILLINOIS ACCESSIBILITY CODE (71 ILL. ADM. CODE 400).

Jason E. Green

DATE: 02-26-21

JASON E. GREEN - P.E. # 062-054460
DATE OF EXPIRATION - NOVEMBER 30, 2021

NOTE: SIGNED AND SEALED FOR SHEETS T-1.0 THROUGH EX-1.0




CALL JULIE TOLL FREE
(800)842-0123
OPERATES 24 HOURS A
DAY 365 DAYS A YEAR



CALL
(800)842-0123
48 HOURS BEFORE
YOU DIG

CONTRACTOR MUST LOCATE PRIVATE UTILITIES IN AREA OF CONSTRUCTION PRIOR TO PROCEEDING WITH WORK.


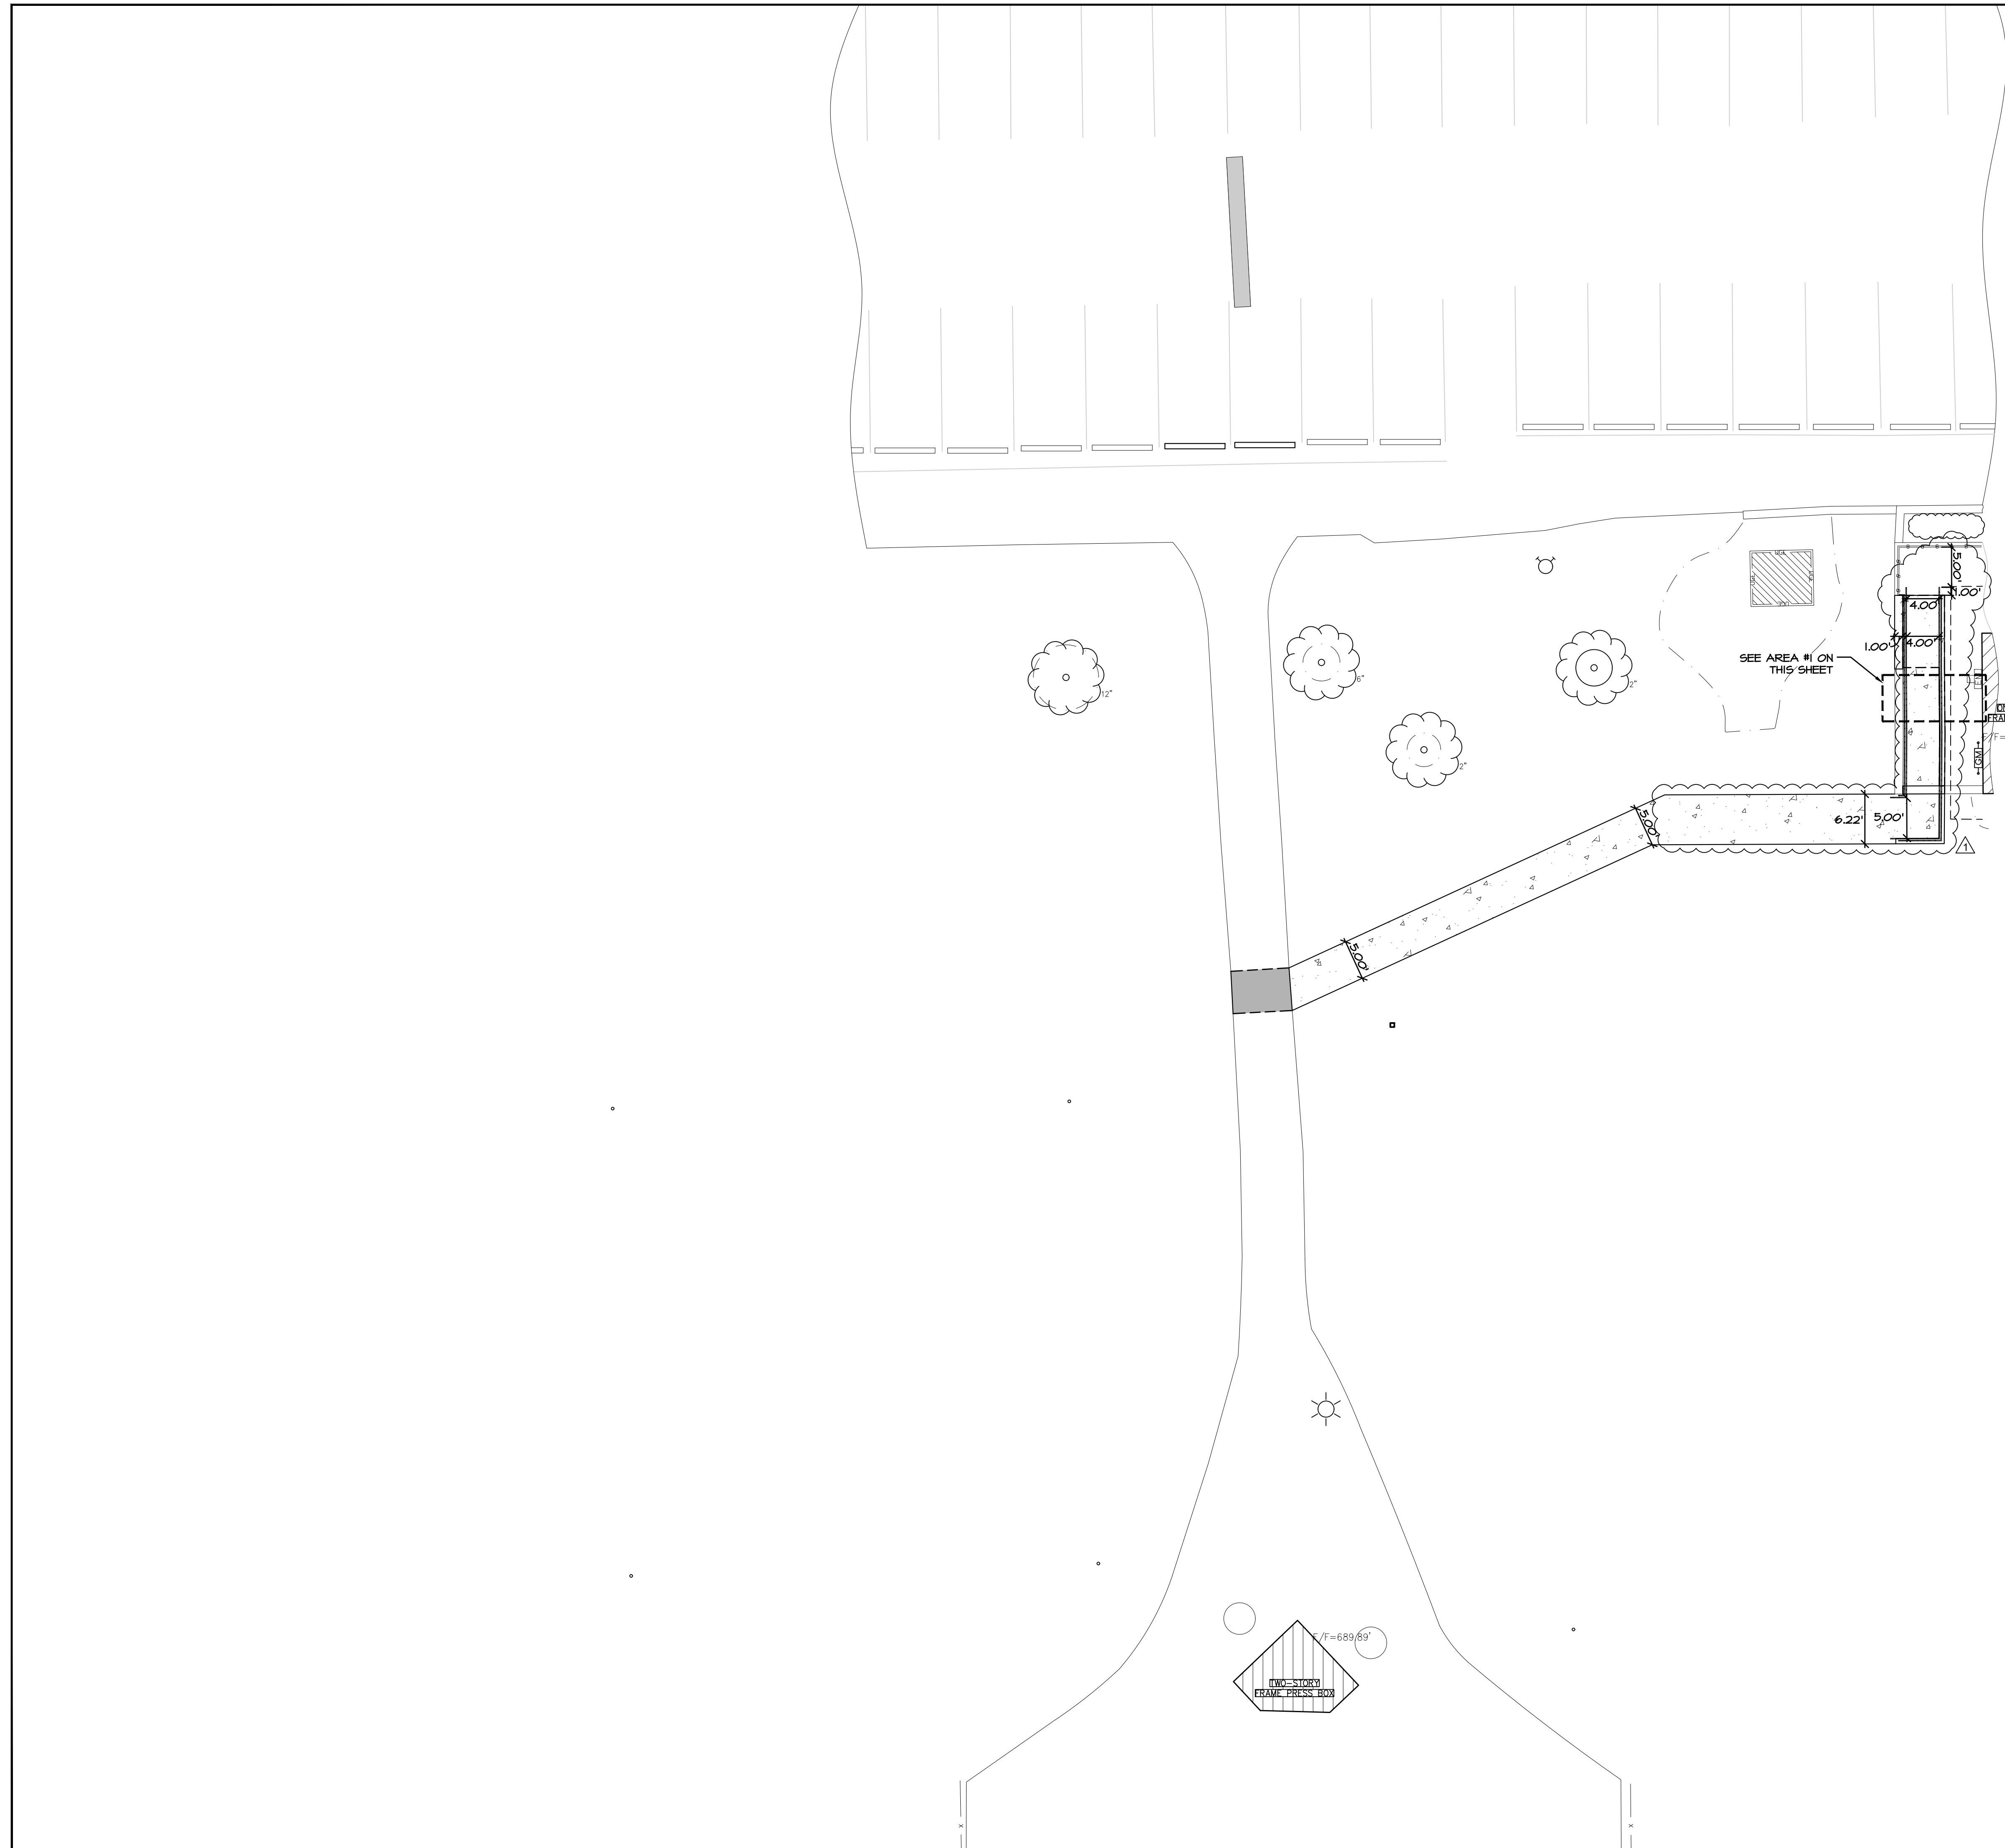


SITE GEOMETRIC NOTES:

- A. EXISTING CONDITIONS AND TOPOGRAPHY SHOWN REPRESENTS SITE CONDITIONS PER THE TOPOGRAPHIC SURVEY LAST DATED 01-14-21, PREPARED BY W.T. GROUP. CONTRACTOR SHALL FIELD VERIFY EXISTING ELEVATIONS AND CONDITIONS (INCLUDING BUT NOT LIMITED TO VERIFICATION OF CONTROL AND ALL UTILITIES WHETHER DEPICTED OR NOT) PRIOR TO CONSTRUCTION AND NOTIFY ENGINEER OF ANY DISCREPANCIES.
- B. ALL DIMENSIONS SHOWN ARE MEASURED FROM EDGE OF PAVEMENT TO EDGE OF PAVEMENT OR FACE OF CURB UNLESS OTHERWISE NOTED.
- C. SEE THE ARCHITECTURAL PLANS FOR THE DESIGN OF ALL BUILDING ENTRIES.
- D. CONSTRUCTION SURVEY AND STAKEOUT SHALL BE THE RESPONSIBILITY OF THE CONTRACTOR.
- E. CONTRACTOR SHALL HIRE A PRIVATE UTILITY LOCATOR TO LOCATE UTILITIES PRIOR TO CONSTRUCTION AND SHALL CONTACT THE SITE ENGINEER IF A CONFLICT EXISTS.
- F. CONTRACTOR SHALL CONTACT J.U.L.I.E. (811 OR 1-800-842-0123) AND/OR PRIVATE LOCATING SERVICE TO LOCATE ALL UNDERGROUND UTILITY LINES PRIOR TO STARTING ANY DEMOLITION AND/OR EXCAVATION. EXACT LOCATIONS OF ANY EXISTING ELECTRIC, GAS, TELEPHONE, ETC. LINES ARE UNKNOWN.
- G. ASPHALT PAVEMENT MARKINGS SHALL BE MADE WITH HIGH QUALITY PAINT CONFORMING TO ARTICLE 1045.02 OF THE IDOT STANDARD SPECIFICATIONS.
- H. ALL PAINTED CURBS ON SITE TO BE REPAINTED FOLLOWING RESURFACING OF THE PARKING LOT. MATCH EXISTING COLOR, REPAINT WITH HIGH QUALITY PAINT.

HATCH LEGEND

NEW 5" CONCRETE RAMP AND SIDEWALK 5" PORTLAND CEMENT CONCRETE 4" CA-6	
NEW ASPHALT PAVEMENT 1-3/4" HMA SURFACE COURSE 2-1/4" HMA BINDER COURSE 10" CA-6	

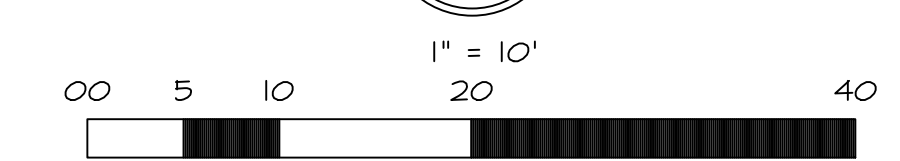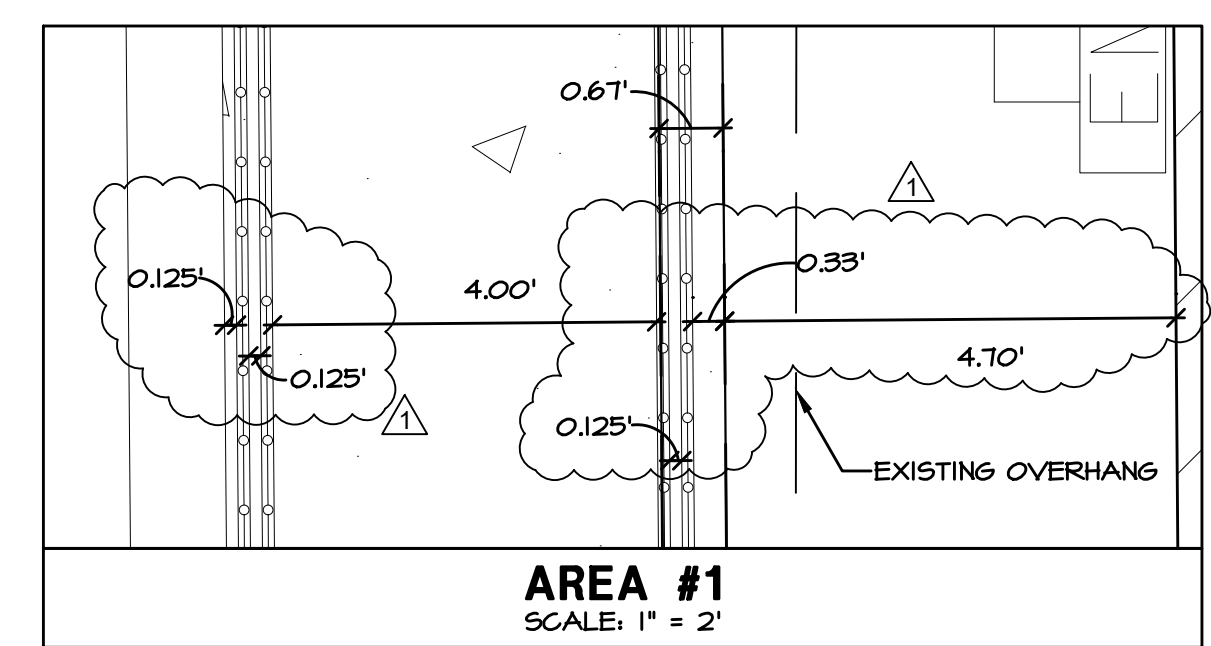


WT GROUP
Engineering with Precision, Pace and Passion.
2875 Pulaski Avenue | Itasca, Illinois, IL 60143
T: 224.293.6333 | F: 224.293.6444
wengr.com
IL License No: 184.007570-0015 Expires: 04.30.2021
© COPYRIGHT 2021 THE W.T. GROUP, LLC

COMMUNITY ATHLETIC FIELDS ELK GROVE
ADA RAMP
DEVON AVE. & ARLINGTON HEIGHTS RD.
ITASCA, IL 60143

ISSUE

TO	DATE
BID SET	2/26/21

CHECK: JEG
DRAWN: RM
JOB: 2001753C

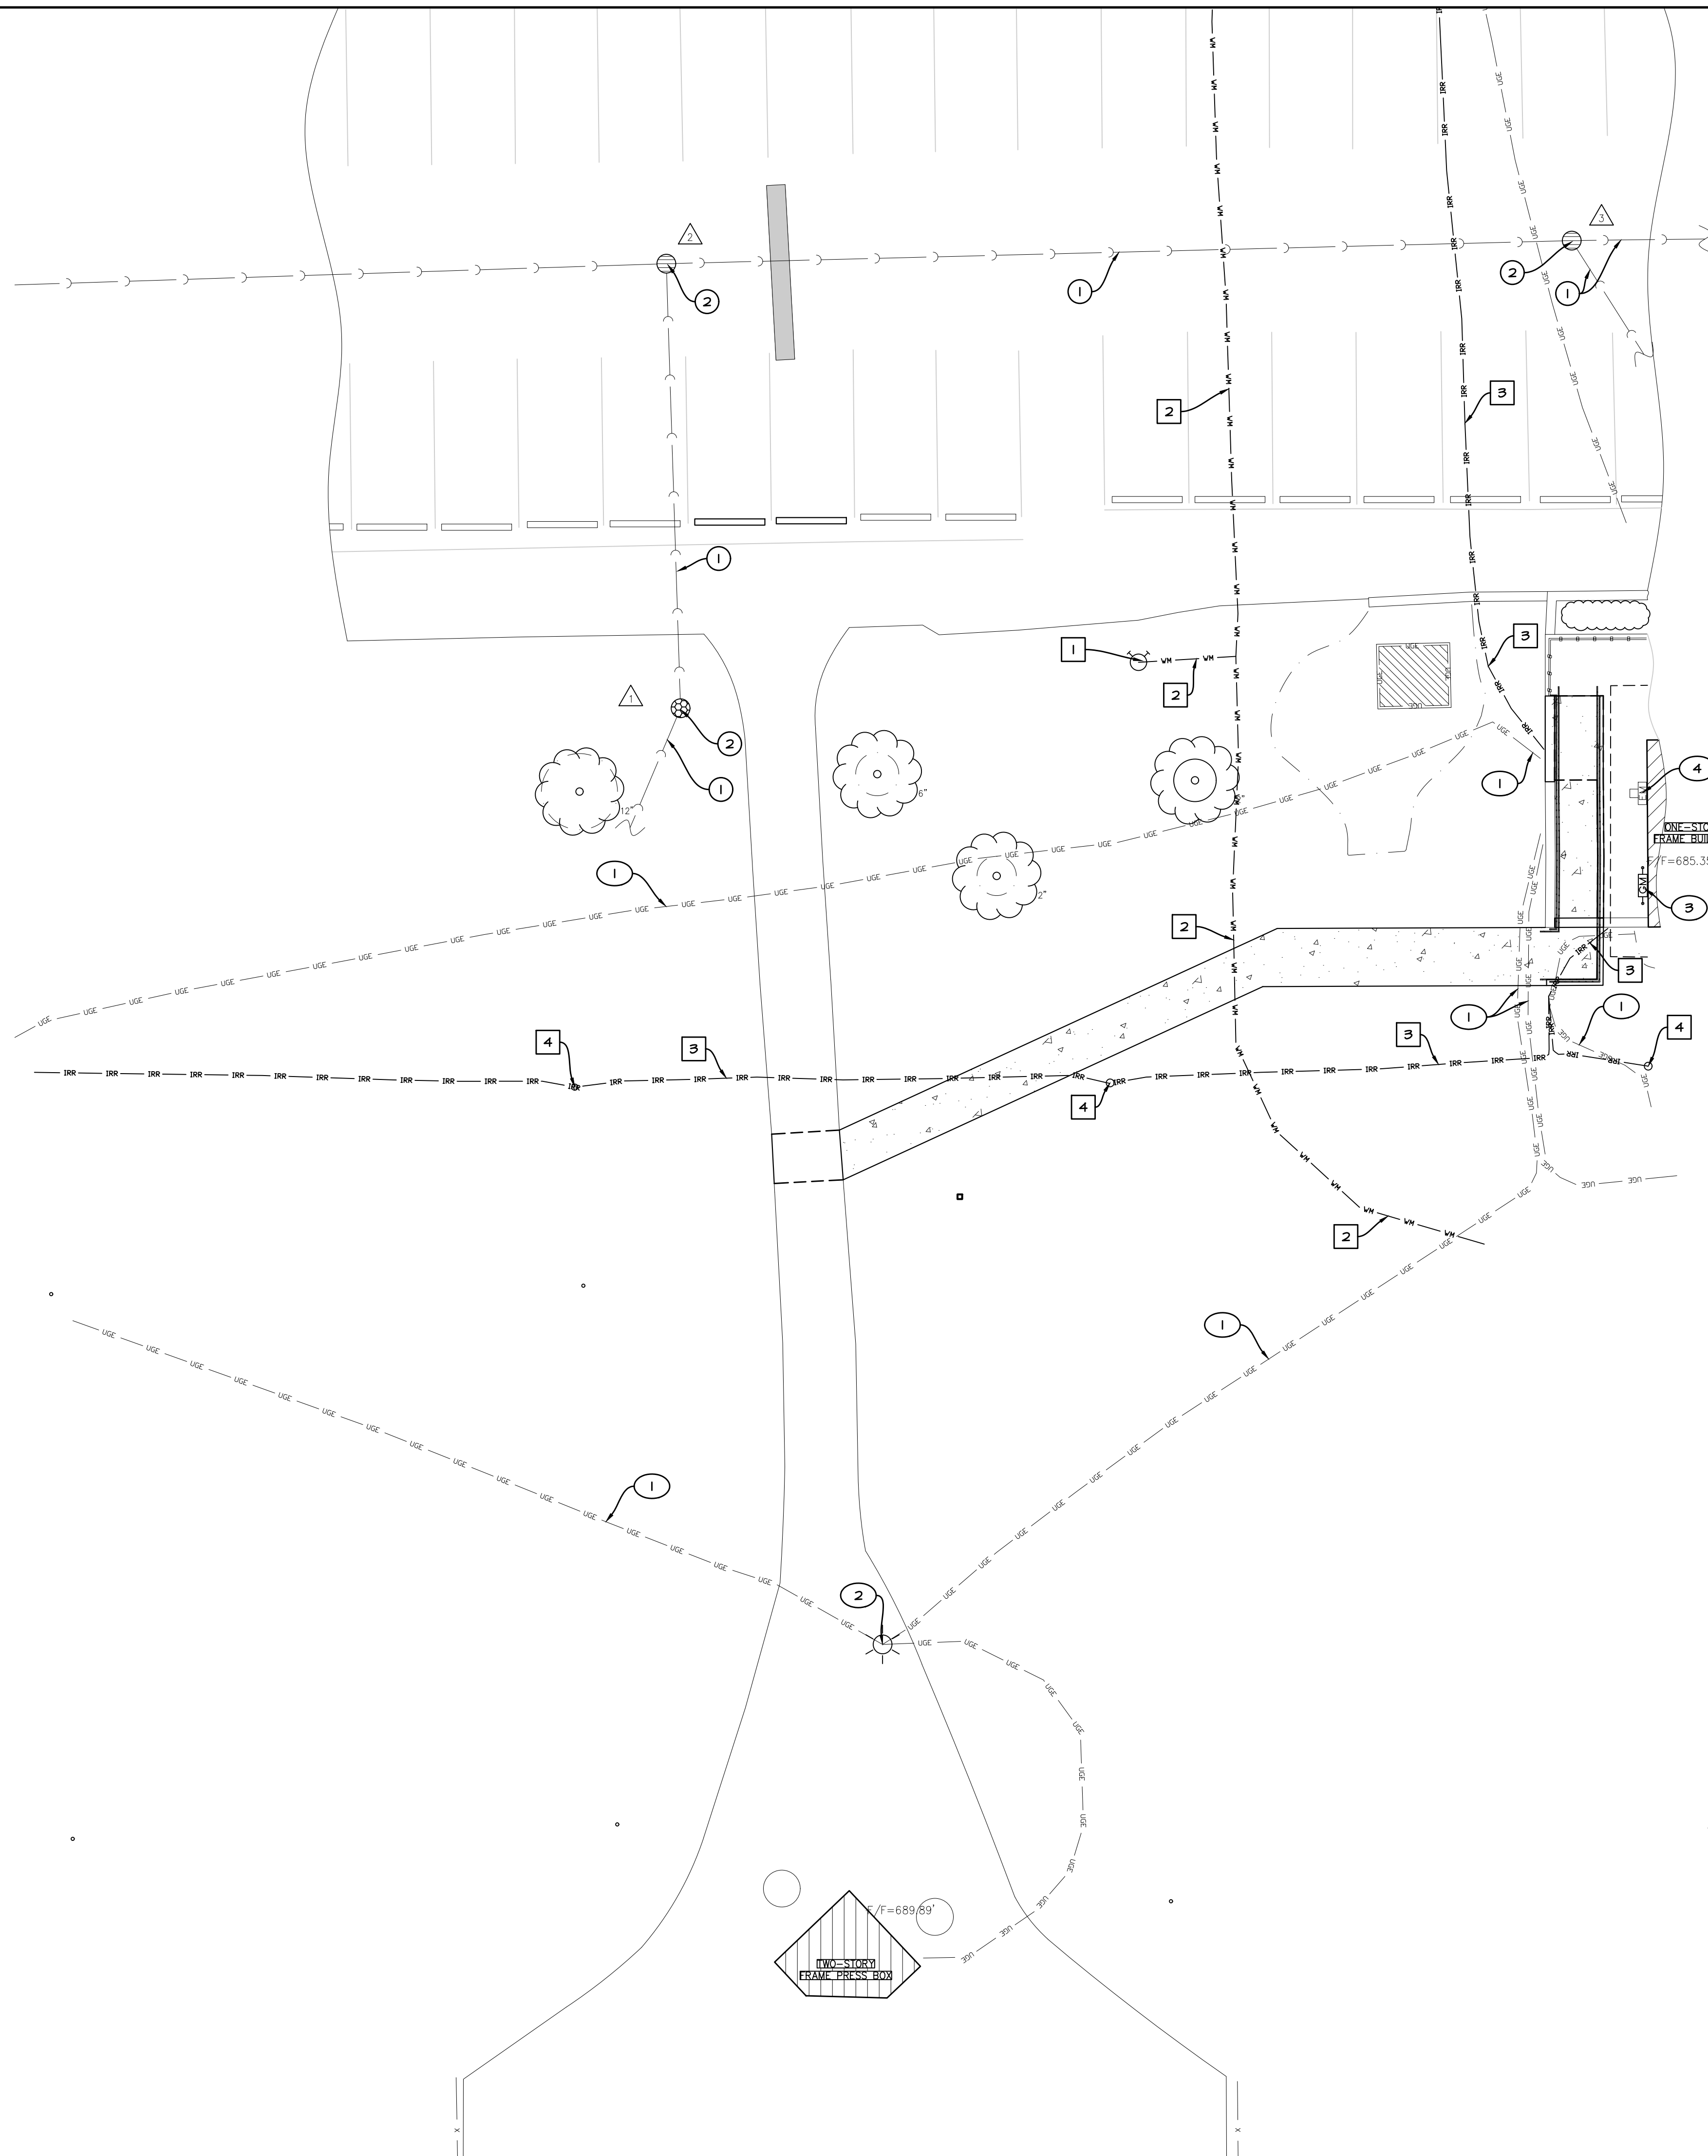

SITE UTILITY NOTES:

- CONTRACTOR SHALL CONTACT J.U.L.I.E. (811 OR 1-800-842-0123) AND/OR PRIVATE LOCATING SERVICE TO LOCATE ALL UNDERGROUND UTILITY LINES PRIOR TO STARTING ANY DEMOLITION AND/OR EXCAVATION. EXACT LOCATIONS OF ANY EXISTING ELECTRIC, GAS, TELEPHONE, ETC. LINES ARE UNKNOWN.
- CONTRACTOR TO UTILIZE CARE WHEN WORKING NEAR EXISTING UTILITIES TO REMAIN. ANY DAMAGE TO EXISTING UTILITIES NOT NOTED TO BE REMOVED SHALL BE REPAIRED AT THE CONTRACTOR'S EXPENSE AND TO THE SATISFACTION OF THE OWNER AND/OR ENGINEER.
- CONTRACTOR SHALL EXCAVATE AND VERIFY IN FIELD ALL EXISTING UTILITY LOCATIONS, SIZES, CONDITIONS AND ELEVATIONS AT PROPOSED POINTS OF CONNECTION PRIOR TO ANY UNDERGROUND CONSTRUCTION. CONTRACTOR SHALL NOTIFY THE OWNER AND ENGINEER OF ANY DISCREPANCIES OR CONFLICTS PRIOR TO PROCEEDING WITH CONSTRUCTION.
- REFER TO THE GENERAL NOTES AND SPECIFICATION SHEETS FOR ALL PIPE MATERIAL AND JOINT SPECIFICATIONS.
- CONTRACTOR SHALL RESTORE ALL DISTURBED AREAS OUTSIDE OF CONSTRUCTION LIMITS TO ORIGINAL CONDITION OR BETTER.
- CONTRACTOR SHALL VERIFY IN FIELD EXACT SIZE, MATERIAL, INVERT, PIPE ROUTING, AND SLOPE OF ALL EXISTING UTILITIES AND NOTIFY THE OWNER AND ENGINEER OF ANY DISCREPANCIES OR CONFLICTS PRIOR TO CONSTRUCTION.
- THE CONTRACTOR IS RESPONSIBLE FOR THE STABILITY OF UTILITY TRENCHES DURING CONSTRUCTION AND SHALL PROVIDE TEMPORARY SHORING AND BRACING AS NECESSARY TO MAINTAIN STABILITY UNTIL CONSTRUCTION OF THE UTILITY IS COMPLETE IN ORDER TO MEET OSHA AND LOCAL CODES, AS WELL AS MANUFACTURER'S REQUIREMENTS.
- ALL RCP STORM SEWER PIPE SHALL BE REINFORCED CONCRETE PIPE, CLASS IV, PER ASTM C-76 WITH FLEXIBLE (G-RING) GASKET JOINTS IN CONFORMANCE WITH ASTM C-443 AND SECTION 31-1.03 OF THE "STANDARD SPECIFICATIONS". TRENCH BACKFILL MATERIAL SHALL BE PLACED AND COMPACTED TO A MINIMUM OF 95% MODIFIED PROCTOR DENSITY (ASTM D-1587) OVER ALL UNDERGROUND UTILITIES WHICH ARE CONSTRUCTED UNDER OR WITHIN 2 FEET OF ANY PROPOSED OR EXISTING PAVEMENT OR SIDEWALKS IN ACCORDANCE WITH THE STANDARD SPECIFICATIONS FOR ROAD AND BRIDGE CONSTRUCTION.
- ADJUST RIM ELEVATIONS OF EXISTING STRUCTURES IN PAVEMENT AS NECESSARY TO MEET PROPOSED FINISHED GRADE.
- CONTRACTOR TO COORDINATE ALL CONNECTIONS TO CITY UTILITIES AND STORM SEWERS WITH THE PUBLIC WORKS DEPARTMENT.
- CONTRACTOR TO USE CAUTION WHEN EXCAVATING AT EXISTING UTILITY LINES.
- ALL STORM MANHOLES SHALL HAVE OPEN LIDS UNLESS OTHERWISE SPECIFIED.

UTILITY LEGEND

- EXISTING STORM SEWER
- PROPOSED STORM SEWER
- EXISTING WATER MAIN
- EXISTING UNDERGROUND ELECTRIC
- EXISTING IRRIGATION LINE
- PROPOSED RIM ELEVATION
- PROPOSED INVERT ELEVATION
- FINISHED FLOOR ELEVATION
- ADJUST EXISTING RIM ELEVATION
- EXISTING CLOSED MANHOLE
- EXISTING OPEN GRATE MANHOLE
- EXISTING BEEHIVE GRATE MANHOLE
- EXISTING CURB INLET
- EXISTING FIRE HYDRANT
- EXISTING VALVE VAULT
- EXISTING B-BOX

STORM SEWER

- EXISTING STORM SEWER TO REMAIN.
- EXISTING STORM STRUCTURE TO REMAIN.

WATER

- EXISTING FIRE HYDRANT AND ASSOCIATED ITEMS TO REMAIN.
- EXISTING WATER MAIN TO REMAIN.
- EXISTING IRRIGATION LINE TO REMAIN.
- EXISTING IRRIGATION CONTROL VALVE TO REMAIN.

MISCELLANEOUS UTILITY

- EXISTING UNDERGROUND ELECTRIC LINE TO REMAIN.
- EXISTING AREA LIGHT TO REMAIN.
- EXISTING EXISTING GAS METER AND ASSOCIATED ITEMS TO REMAIN.
- EXISTING ELECTRIC METER AND ASSOCIATED ITEMS TO REMAIN.

EXISTING UTILITY DATA

- 24" CONCRETE STRUCTURE
INV=687.91' (6" PVC N)
INV=681.81' (4" CPP SW)
- 24" CONCRETE STRUCTURE
INV=677.67' (10" PVC E/W)
INV=677.67' (6" PVC S)
TOP OF WATER=677.75'
- 36" CONCRETE STRUCTURE
INV=677.55' (10" PVC W)
INV=677.42' (12" METAL E)
INV=677.61' (6" PVC SE)
TOP OF WATER=677.51'

AQUATIC \ CIVIL \ MECHANICAL \ ELECTRICAL \ PLUMBING \ TELECOMMUNICATION \ STRUCTURAL \ ACCESSIBILITY CONSULTING \ DESIGN & PROGRAM MANAGEMENT \ LAND SURVEY

WT GROUP
 Engineering with Precision, Pace and Passion.
 2875 Pulaski Avenue | Hawthorn Estates, IL 60192
 T: 224.293.6333 | F: 224.293.6444
 wengineering.com
 IL License No: 184.007570/0015 Expires: 04.30.2021
 © COPYRIGHT 2021 THE WT GROUP, LLC


WT Group
 Engineering • Design • Consulting

COMMUNITY ATHLETIC FIELDS ELK GROVE
 ADA RAMP
 DEVON AVE & ARLINGTON HEIGHTS RD.
 ITASCA, IL 60143

ISSUE
 TO DATE
 BID SET 2/26/21

CHECK:JEG
 DRAWN:RM
 JOB:2001753C

C-5.0
 SITE UTILITY PLAN

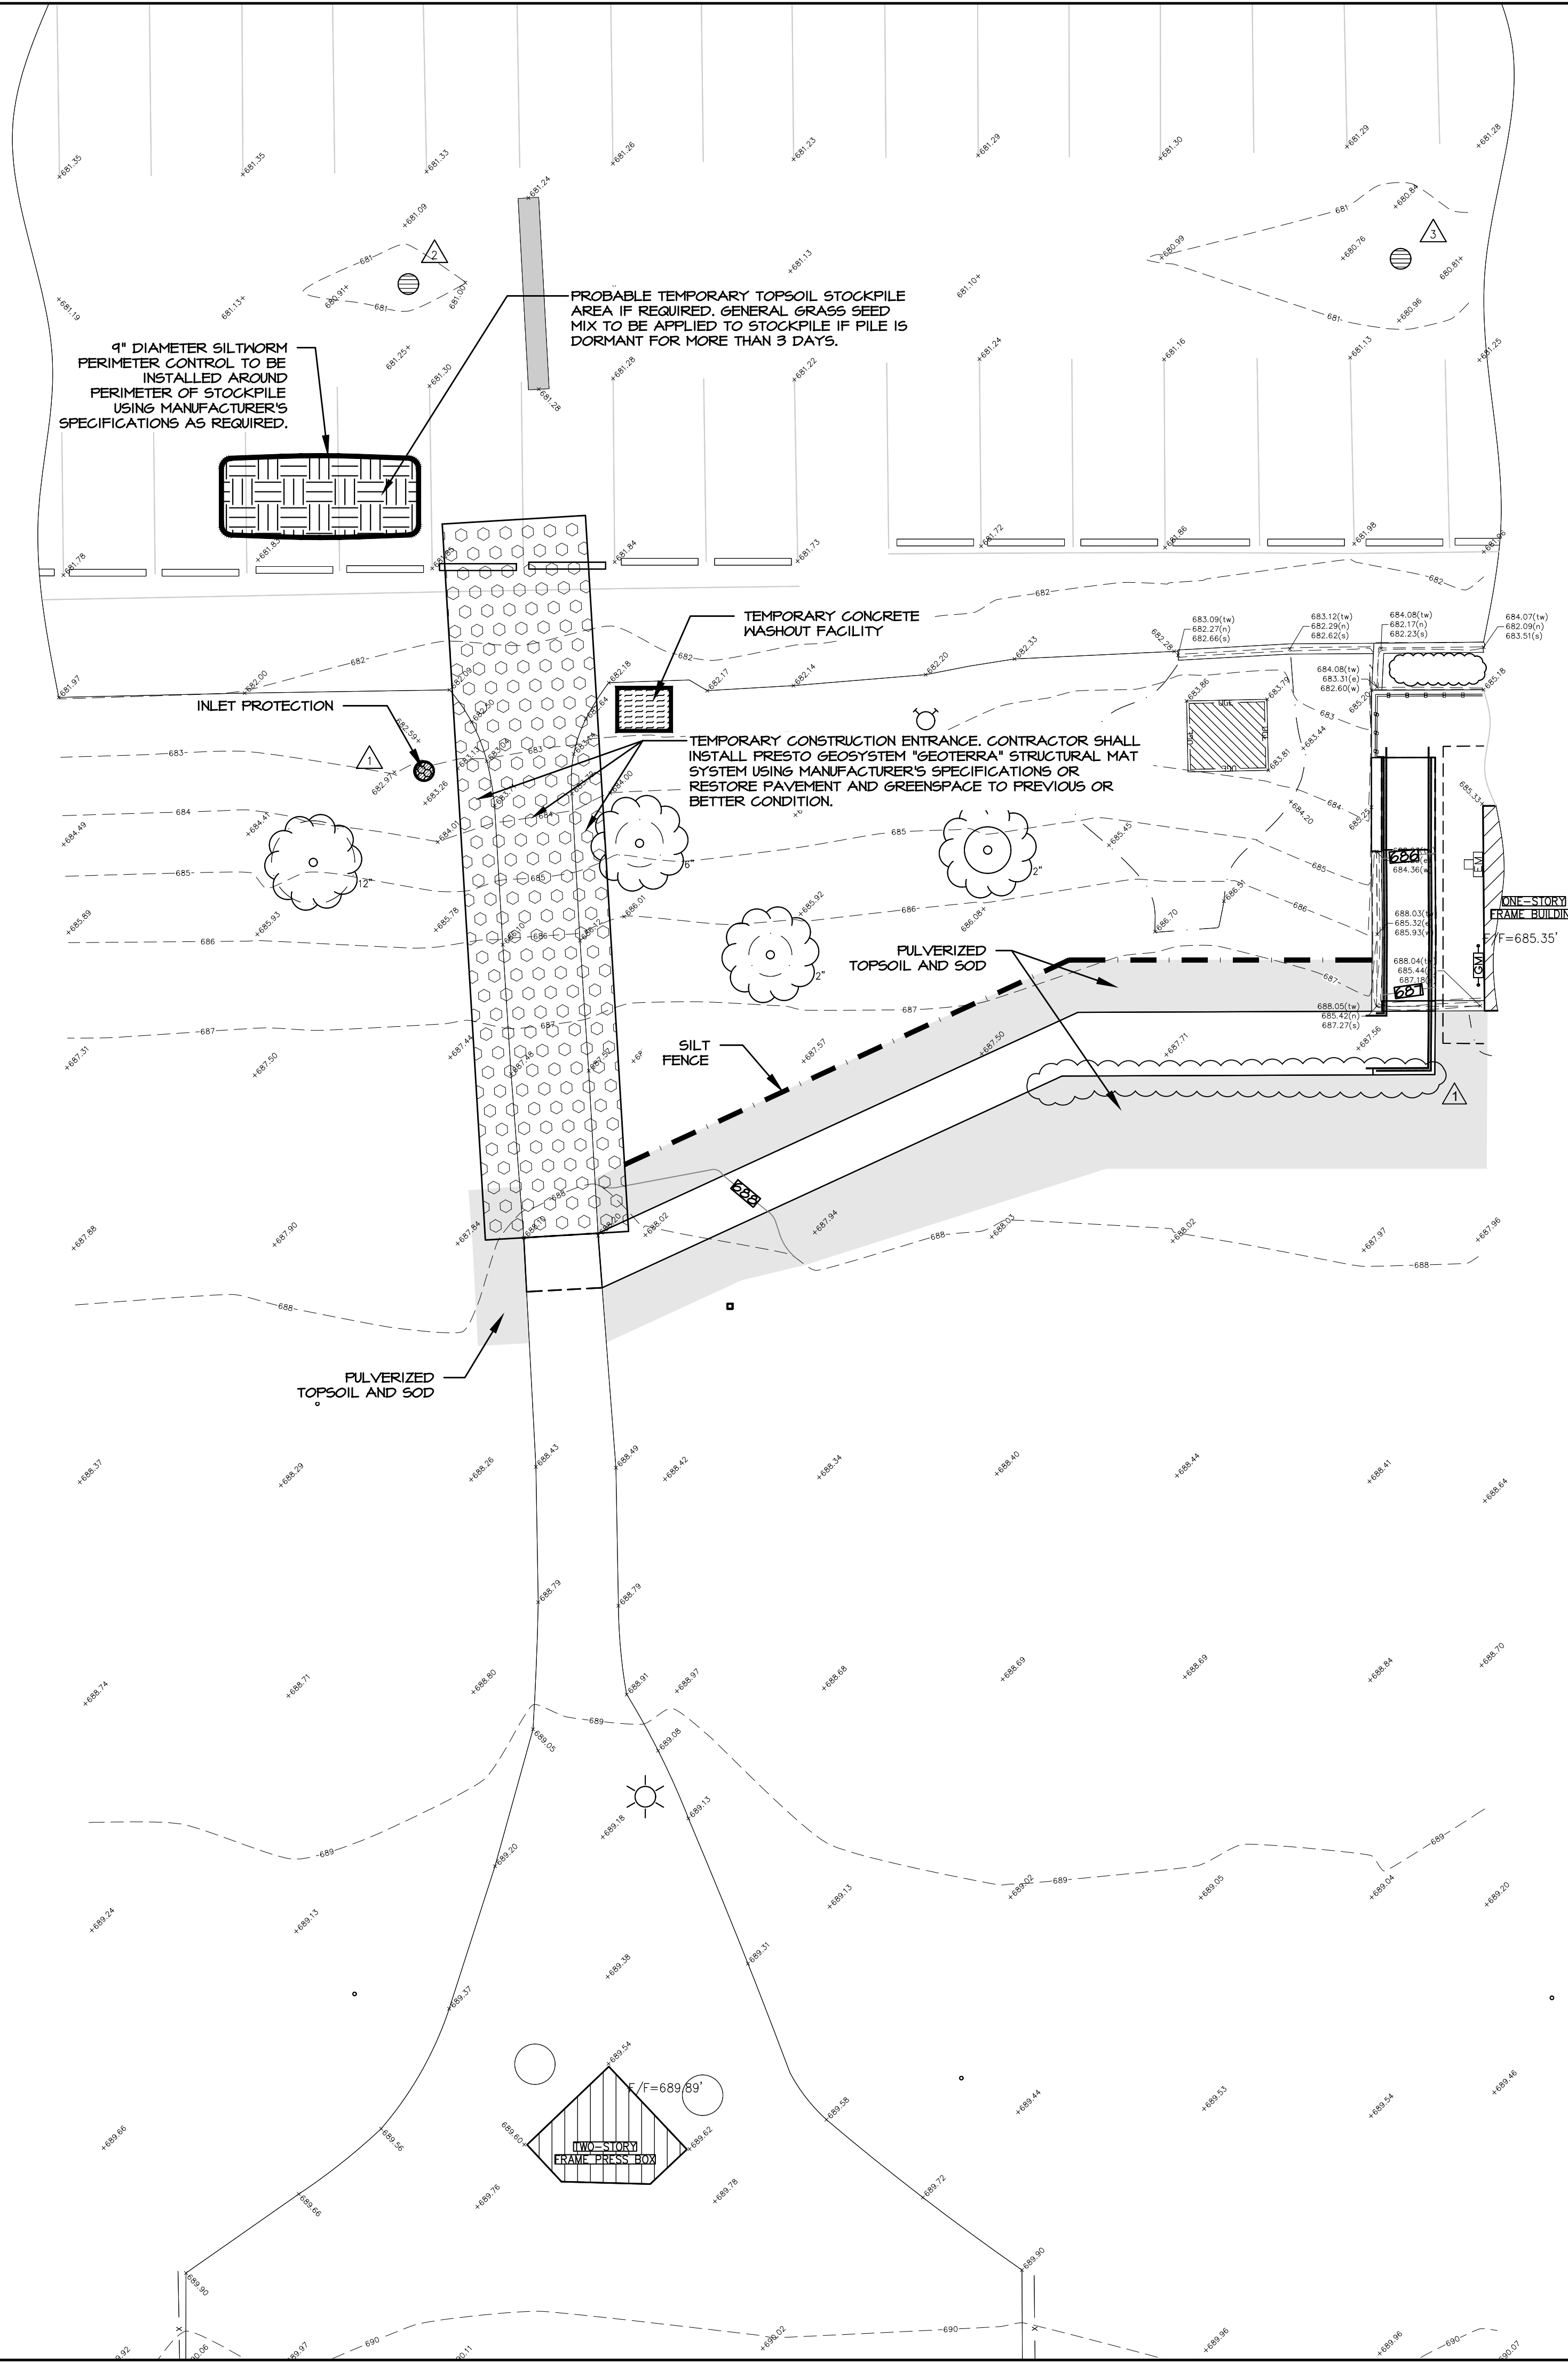

SWPPP NOTES:

- A. ALL DISTURBED GREEN SPACES ON THE SITE SHALL BE RESTORED ACCORDING TO THE SEED BED PREPARATION SPECIFICATIONS BELOW AND BLANKETED OR MATTED AS SHOWN ON THE PLANS.
- B. TEMPORARY OR PERMANENT STABILIZATION SHALL OCCUR IMMEDIATELY WHENEVER EARTH DISTURBING ACTIVITIES HAVE PERMANENTLY OR TEMPORARILY CEASED ON ANY PORTION OF THE SITE. TEMPORARY STABILIZATION SHALL CONSIST OF THE INSTALLATION OF TEMPORARY SEEDING.
- C. CONTRACTOR TO INSTALL TEMPORARY CONSTRUCTION ENTRANCES AS NECESSARY TO EXCAVATE AREAS AND HAUL SOILS ON-SITE. TRACKING OF DEBRIS ON SITE WILL NOT BE TOLERATED. ANY DEBRIS LEFT OUTSIDE OF THE PROJECT LIMITS MUST BE CLEANED IMMEDIATELY.
- D. EROSION CONTROL BLANKETS AND TURF REINFORCEMENT MATS SHALL BE INSTALLED USING 6" BIO-STAKES AS MANUFACTURED BY NORTH AMERICAN GREEN. METAL STAKES AND STAPLES ARE PROHIBITED.
- E. CONTRACTOR SHALL PROVIDE ALL NECESSARY MAINTENANCE FOR THE SEDIMENT AND EROSION CONTROL MEASURES FOR THE DURATION OF THE PROJECT.
- F. CONTRACTOR SHALL BE RESPONSIBLE FOR PROVIDING ALL STORMWATER POLLUTION PREVENTION PLAN (SWPPP) INSPECTIONS, INSPECTION REPORTS, CORRECTIVE ACTION FORMS, SWPPP AMENDMENT LOGS, SUBCONTRACTOR CERTIFICATIONS/AGREEMENTS, GRADING AND STABILIZATION ACTIVITIES LOGS, SWPPP TRAINING LOGS, AND DELEGATION OF AUTHORITY FORMS FOR THE DURATION OF THE PROJECT.
- G. CONTRACTOR SHALL PROVIDE COPIES OF ALL SWPPP REPORTS, FORMS, AND LOGS TO THE WT GROUP ONCE THE SITE HAS BEEN STABILIZED. THE CONTRACTOR SHALL MAINTAIN THESE DOCUMENTS FOR A PERIOD OF 3 YEARS FROM THE FINAL STABILIZATION OF THE SITE.
- H. FOLLOWING THE REMOVAL OF THE SILT FENCE, THE CONTRACTOR SHALL RESTORE THE SILT FENCE TRENCH WITH SOD.
- I. CONTRACTOR SHALL INITIATE STABILIZATION OF ALL DISTURBED AREAS WITHIN ONE CALENDAR DAY.
- J. SEED BED PREPARATION:
 - J.A. ALL STONES, ROCKS, DEBRIS LARGER THAN 1" IN DIAMETER SHALL BE REMOVED.
 - J.B. DISK OR TILL TOPSOIL TO A DEPTH OF 3" AND REDUCE ALL SOIL PARTICLES TO NO LARGER THAN 2". THE SURFACE SHALL BE FREE OF WEEDS, STONES, ROCKS, STICKS, GULLIES, CLOUDS, AND DEBRIS.
 - J.C. THE AREA SHALL BE FINE GRADED.
 - J.D. ANY SOIL AMENDMENTS NEEDED TO ACHIEVE A 90% HEALTHY STAND OF VEGETATION WILL BE ADDED TO THE SOIL AT NO EXTRA CHARGE TO THE OWNER. THE STAND OF VEGETATION WILL NEED TO BE ACCEPTED BY THE ENGINEER.

SWPPP LEGEND

- +000.00— EXISTING SPOT GRADE
- - - - - EXISTING CONTOUR LINE
- - - - - PROPOSED CONTOUR LINE
- OVERLAND FLOW ARROW
- 100 YEAR OVERLAND FLOW ROUTE
- EMERGENCY OVERFLOW ARROW
- ADJUST → ADJUST EXISTING RIM ELEVATION
- EXISTING CLOSED MANHOLE
- ⊙ EXISTING OPEN GRATE MANHOLE
- ⊙ EXISTING BEEHIVE GRATE MANHOLE
- ⊙ EXISTING CURB INLET
- ⊙ EXISTING FIRE HYDRANT
- ⊙ EXISTING VALVE VAULT
- ⊙ EXISTING B-BOX
- ⊙ PROPOSED INLET
- ⊙ PROPOSED OPEN LID MANHOLE / CATCH BASIN
- ⊙ PROPOSED CLOSED LID MANHOLE
- - - - - SILT FENCE
- SILTWORM PERIMETER CONTROL
- ⊙ FLEXSTORM CATCH-IT INLET PROTECTION
- ⊙ SILT FENCE INLET PROTECTION WITH STONE COLLAR
- ⊙ RIP RAP
- RESTORE GREEN SPACE WITH PULVERIZED TOPSOIL AND SOD.
- TEMPORARY CONCRETE WASHOUT FACILITY
- TEMPORARY CONSTRUCTION ENTRANCE OR RESTORE PAVEMENT TO BETTER OR WORSE CONDITION
- TEMPORARY PULVERIZED TOPSOIL STOCKPILE IF NECESSARY

AQUATIC \ CIVIL \ MECHANICAL \ ELECTRICAL \ PLUMBING \ TELECOMMUNICATION \ STRUCTURAL \ ACCESSIBILITY CONSULTING \ DESIGN & PROGRAM MANAGEMENT \ LAND SURVEY

WT GROUP
 Engineering with Precision, Pace and Passion.
 2875 Proctor Avenue | Hawthorn Estates, IL 60192
 T: 224.293.6333 | F: 224.293.6444
 wengr.com
 IL License No: 184.0075704015 Expires: 04.30.2021
 © COPYRIGHT 2021 THE WT GROUP, LLC

WT Group
 Engineering • Design • Consulting

COMMUNITY ATHLETIC FIELDS ELK GROVE
 ADA RAMP
 DEVON AVE & ARLINGTON HEIGHTS RD.
 ITASCA, IL 60143

ISSUE
 TO DATE
 BID SET 2/26/21

CHECK:JEG
 DRAWN:RM
 JOB:2001753C

C-6.0
 STORM WATER
 POLLUTION PREVENTION
 PLAN

